
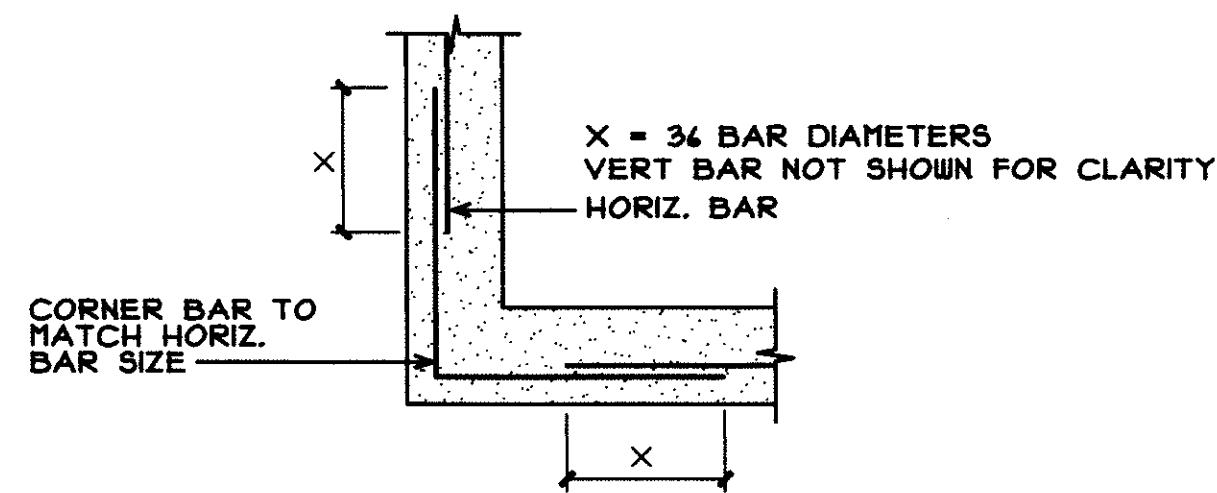


LOW SIDEWALL

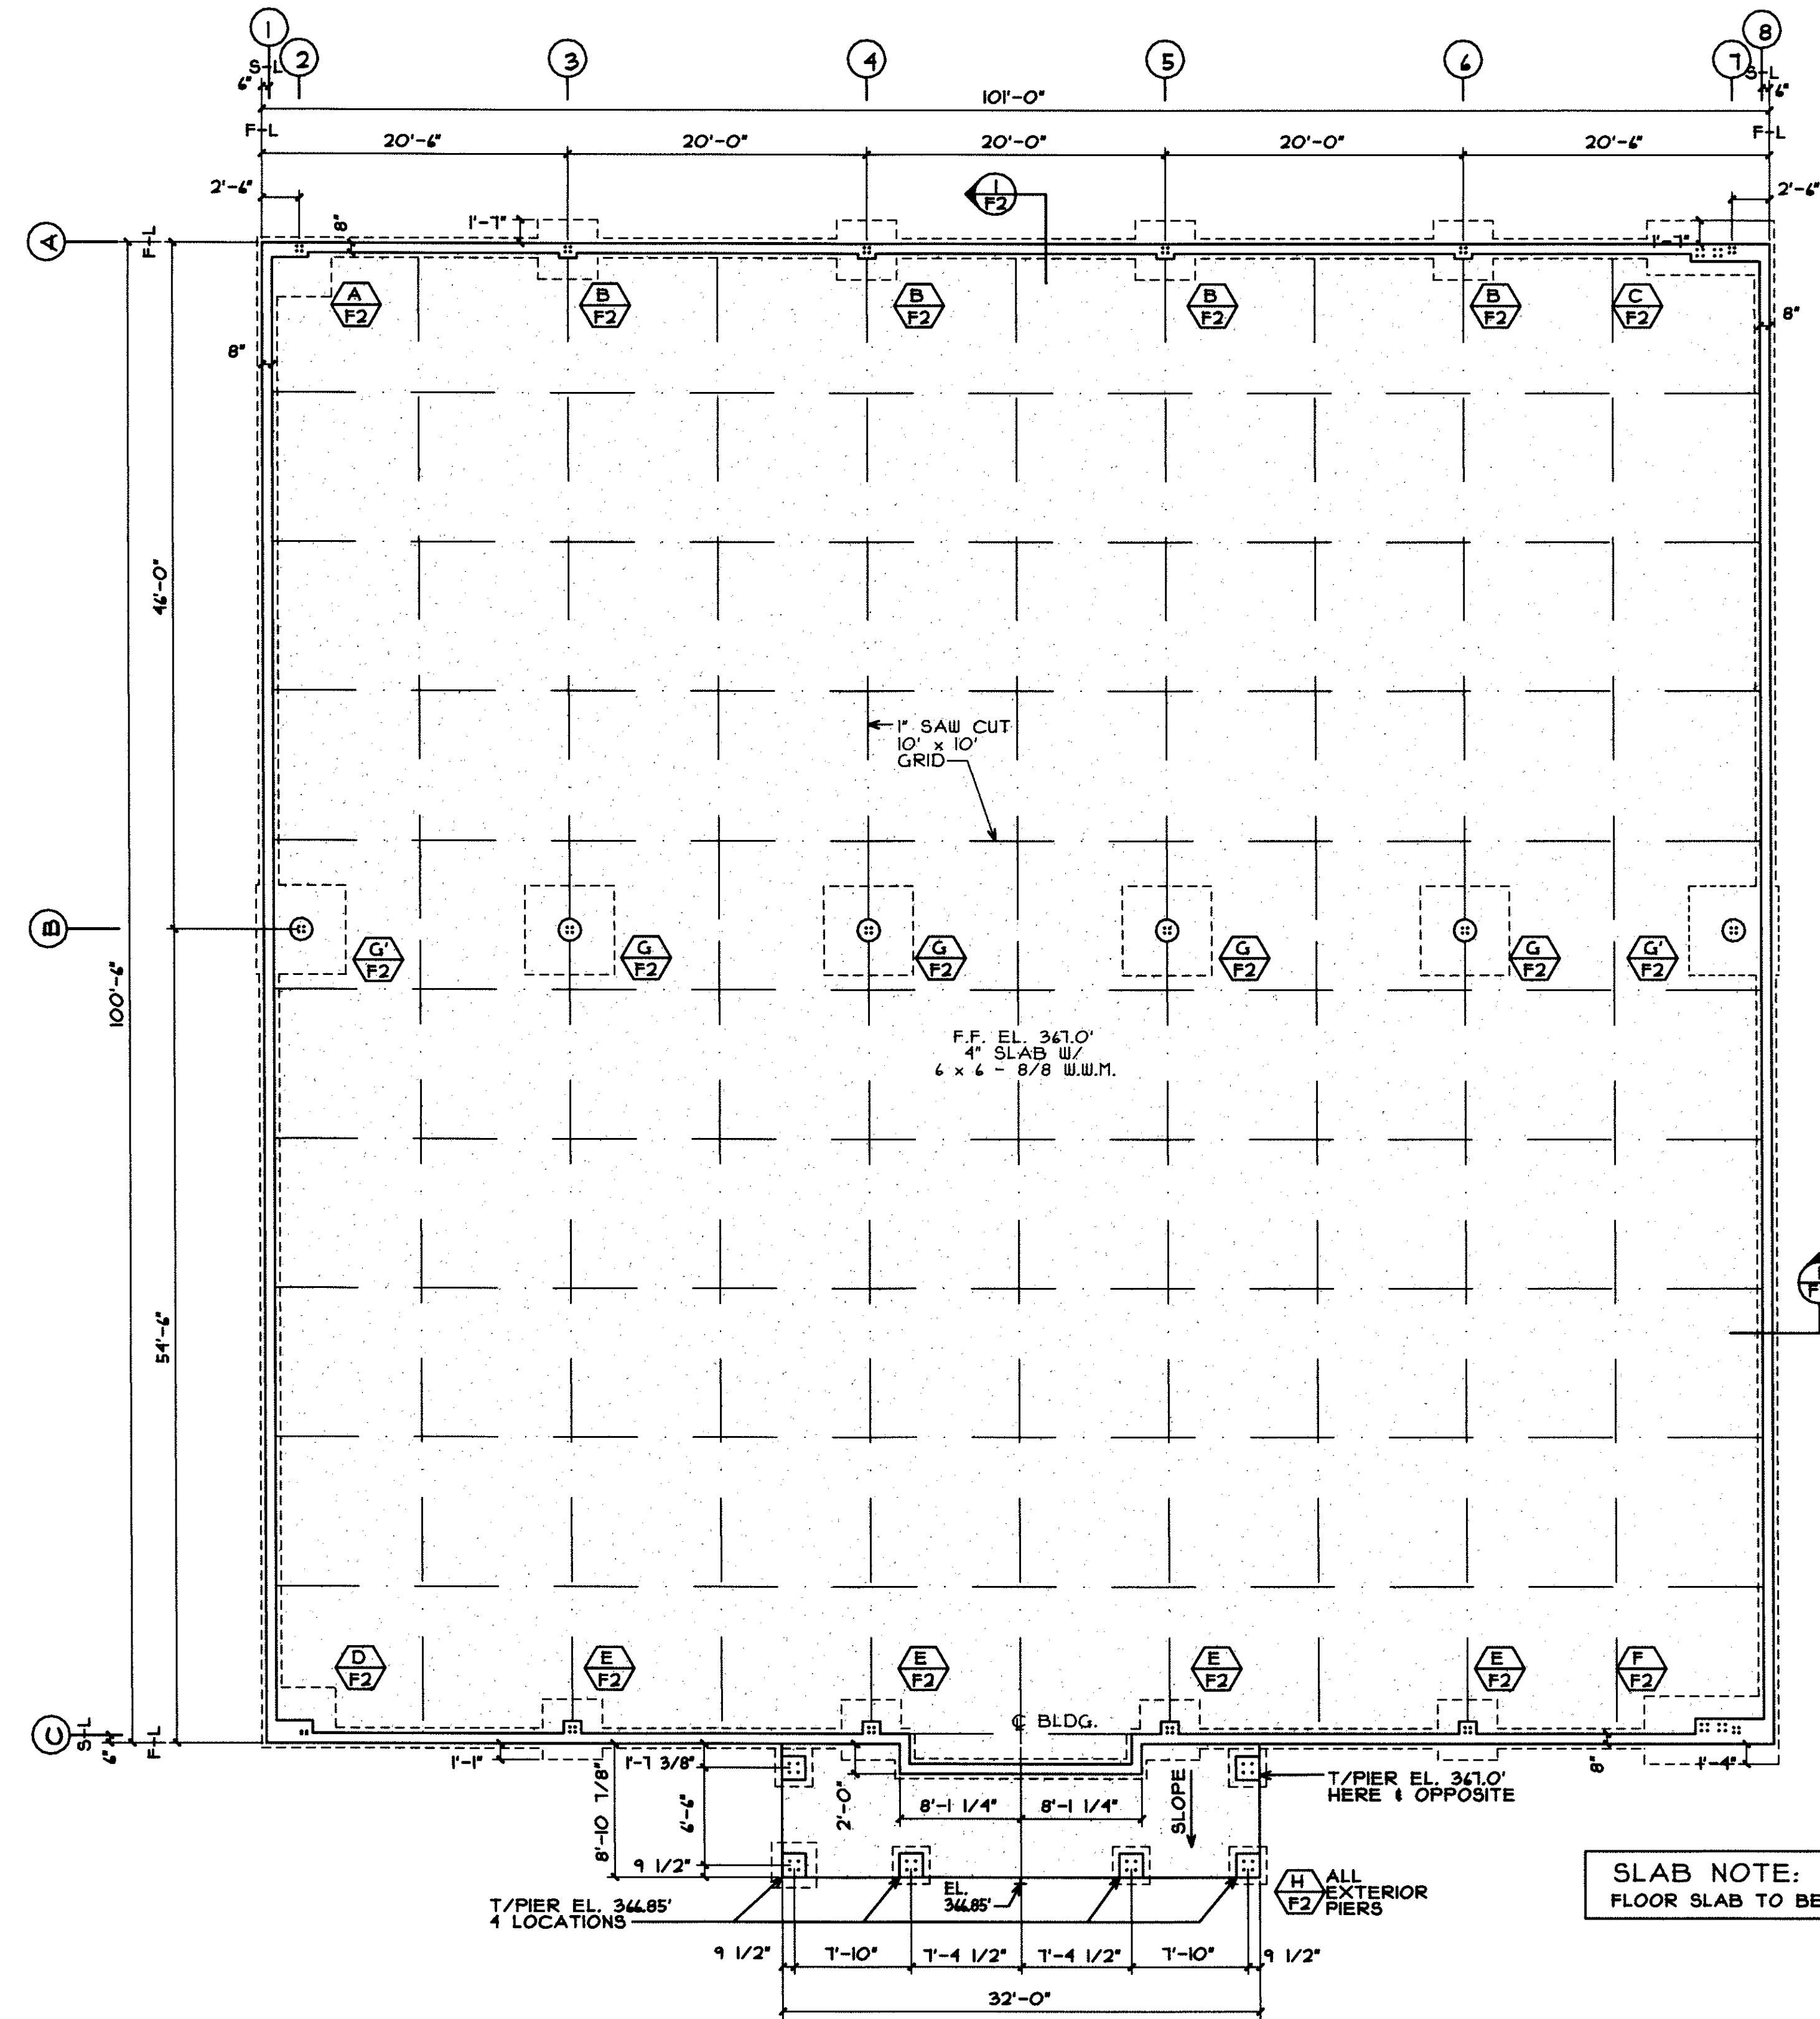

TYP. CORNER BAR DETAIL

DESIGN NOTES:


- 1.) DESIGN SOIL BEARING CAPACITY = 3,000 PSF FOR EXTERIOR FOOTING.
- 2.) DESIGN SOIL BEARING CAPACITY = 3,000 PSF FOR INTERIOR FOOTING.
- 3.) FLOOR SLAB CONCRETE TO HAVE MINIMUM COMPRESSIVE STRENGTH OF 4,000 PSI AT TWENTY-EIGHT (28) DAYS.
- 4.) FOUNDATION CONCRETE TO HAVE MINIMUM COMPRESSIVE STRENGTH OF 4,000 PSI AT TWENTY-EIGHT (28) DAYS.
- 5.) ALL REINFORCING STEEL SHALL CONFORM TO A.S.T.M. A-65 GRADE 20.
- 6.) OVERLAP ALL REBAR 3/4 BAR DIAMETERS MIN. #4 BAR = 1'-0", #5 BAR = 2'-0", #6 BAR = 2'-3".
- 7.) FOUNDATION MUST BE SQUARE, LEVEL, AND SMOOTH.
- 8.) ANCHOR BOLTS TO BE A.S.T.M. A-307 UNLESS OTHERWISE NOTED.
- 9.) LOCATE ANCHOR BOLTS BY MEANS OF A TEMPLATE, DO NOT HAND SET ANCHOR BOLTS.
- 10.) DESIGN LOADS PER 1994 BOCA BUILDING CODE: WIND LOAD = 80 MPH, EXPOSURE 'C', ROOF SNOW LOAD = 10 PSF.

SLAB NOTE:
FLOOR SLAB TO BE ONE PLACEMENT.

REVIEW ONLY

PARAMETRON
20 MAY 99
2011

FILE DRAWING
THIS DRAWING REPRESENTS THE PROJECT AS CONSTRUCTED TO THE BEST KNOWLEDGE OF THE CONTRACTOR

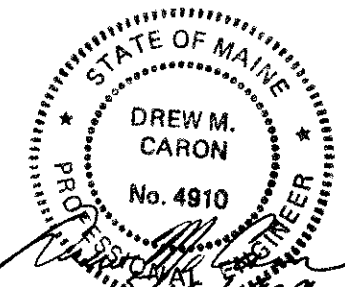

<p>WARNING: THIS DRAWING IS THE PROPERTY AND INSTRUMENT OF SHERIDAN CORPORATION FOR USE WITH THE PROJECT IDENTIFIED BELOW. NO MODIFICATIONS OR CHANGES MAY BE MADE TO THIS DRAWING AND NO USE MAY BE MADE OF THIS DRAWING WITHOUT THE EXPRESS WRITTEN PERMISSION OF SHERIDAN CORPORATION. ANY MODIFICATION, CHANGE OR USE OF THIS DRAWING WITHOUT THE EXPRESS WRITTEN PERMISSION OF SHERIDAN CORPORATION IS WRONGFUL AND IS AT THE USER'S RISK. SHERIDAN DISCLAIMS ANY AND ALL LIABILITY FOR SUCH USE.</p>		<p>Engineering Design For MBNA AMERICA BRACEBRIDGE CORPORATION FARMINGTON, MAINE</p>		<p>JOB NO. 9904</p>
DATE	REVISION	EST. NO	NA	<p>ENGINEERING DWG. NO. FI OF</p>
		SIZE	100 x 100	
		TYPE	NA	<p>TELESALES SITE FOUNDATION PLAN</p>
		DRAWN BY	RS	
5/14/99	FLOOR SLAB NOTE ADDED	APPROVED BY	RAJP	
5/13/99	DET. • B-1 & B-8 REV. TO DETAIL G'	SCALE	1/8" = 1'-0"	
5/11/99	GEN. REV. • EXT. PIERS	DATE	5/11/99	<p>FAIRFIELD PORTLAND MAINE</p>